



Copyright 2004 Philip Aaron Lacy, Architect. All rights reserved. No portion of this document may be reproduced without written permission.

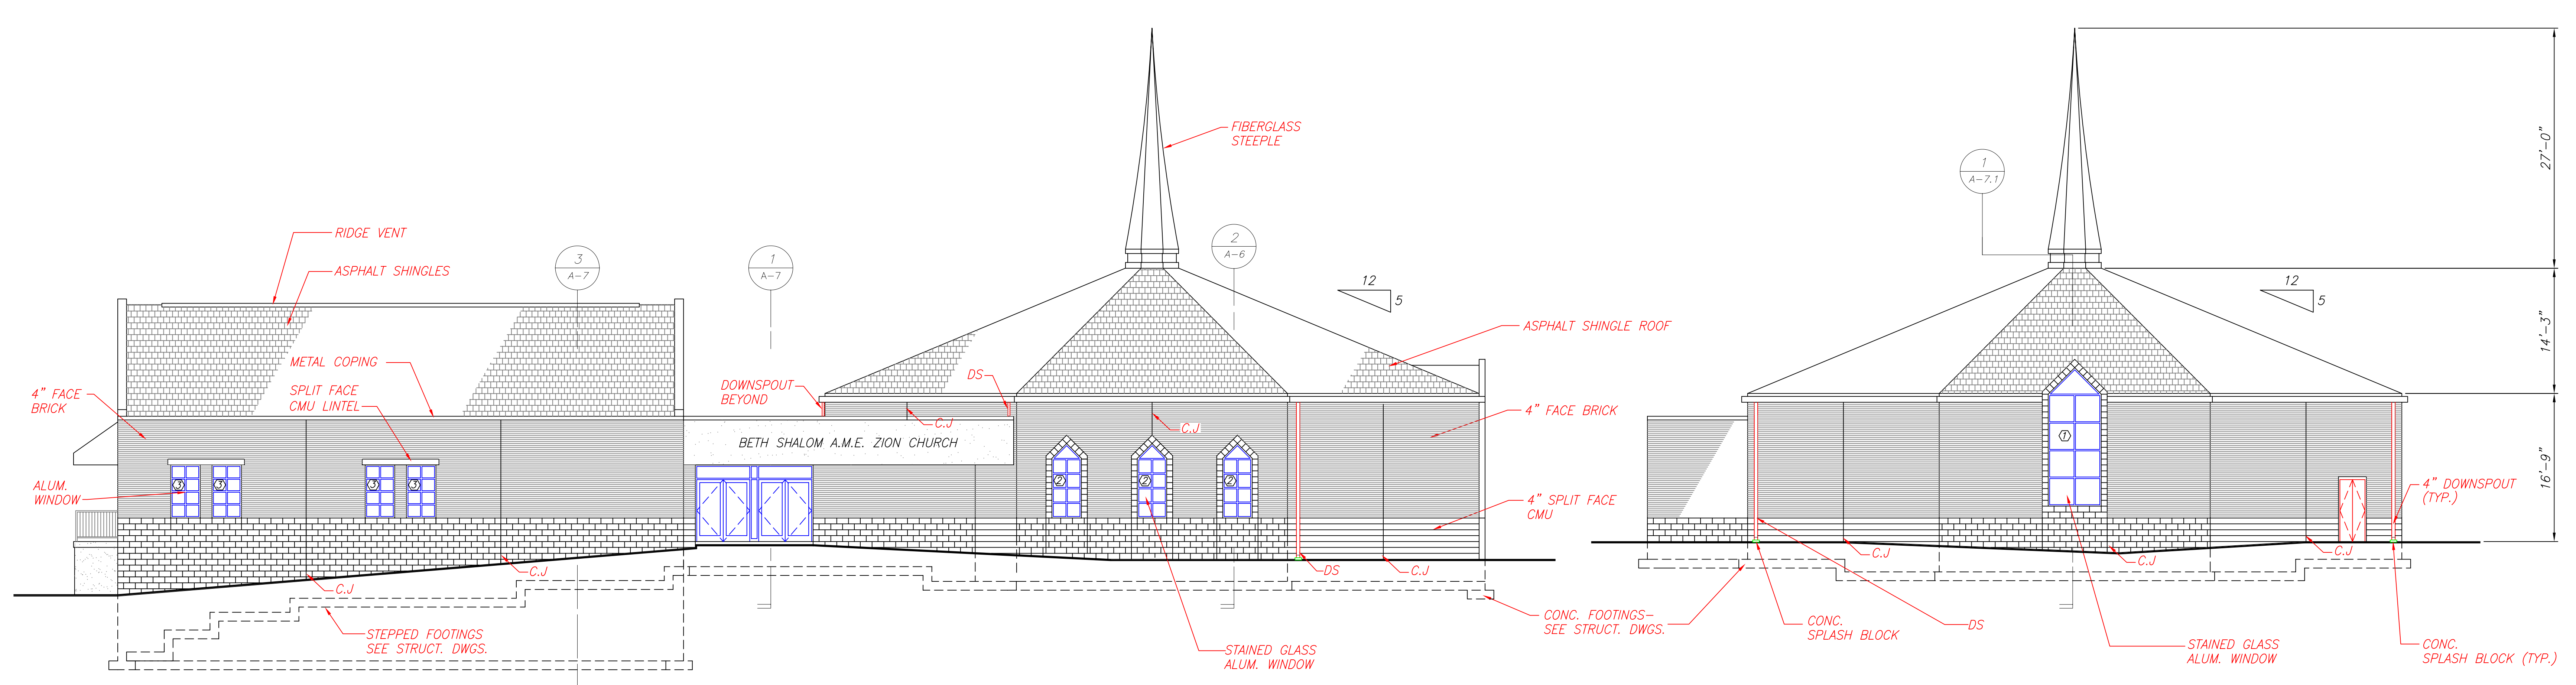

BUILDING ELEVATION
SCALE: 1/8"=1'-0"

BUILDING ELEVATION
SCALE: 1/8"=1'-0"

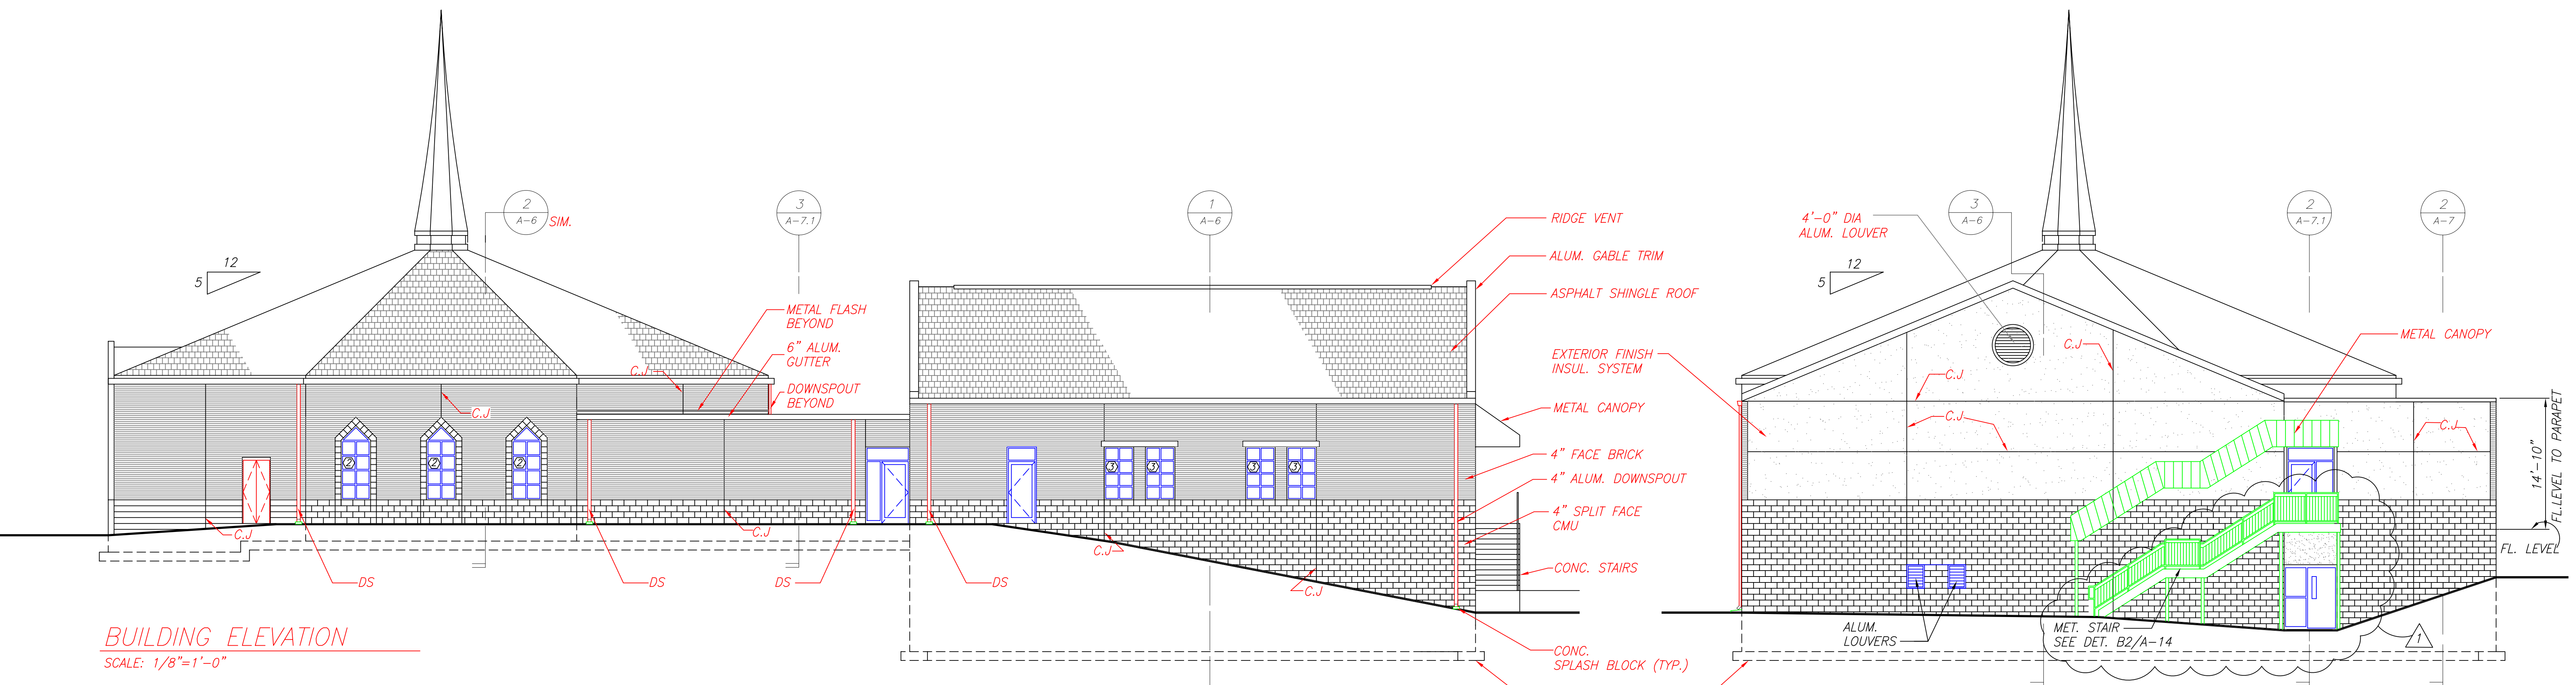

BUILDING ELEVATION
SCALE: 1/8"=1'-0"

BUILDING ELEVATION
SCALE: 1/8"=1'-0"

Date: 1-14-08

Revisions:	COUNTY REVIEW COMMENTS

Consultants:
WARDER & ASSOCIATES INC.
 CHURCH EXPANSION SPECIALISTS
 8016 Old Alexandria Ferry Road
 Clinton, Maryland 20735
 Phone: 301-868-5800

Certification:

Project Title:
BETH SHALOM A.M.E. ZION CHURCH
 2501 RITCHIE ROAD
 DISTRICT HEIGHTS, MARYLAND 20735
BUILDING ELEVATIONS

Philip Aaron Lacy, Architects
 6188 Oxon Hill Road, Suite 303
 Oxon Hill, Maryland 20745
 Phone: 301-567-8223

Date: DEC. 1, 2005
 Scale: 1/8"=1'-0"
 Drawn: PAL
 Checked: PAL
 File No. BETH_A04

Drawing No.
A-4
 of