


FINISH SCHEDULE


ROOM NAME	FLOOR						BASE					WALLS					CEILING			CEILING HT	REMARKS	
	CONCRETE	CERAMIC TILE	VINYL TILE COMP. TILE	CARPET	STONE/TILE	QUARRY TILE	QUARRY TILE	VINYL RUBBER	CERAMIC TILE	STONE/TILE	WOOD	CMU-PAINTED	GYP. BD.-PAINTED	CERAMIC TILE	WOOD WAINSCOT	VINYL WALL CVR.	ACCOUSTICAL	WOOD	GYP. BD.-PAINTED			EXPOSED
OFFICE B1																					8'-0"	
OFFICE B2																					8'-0"	
OFFICE B3																					8'-0"	
WOMEN B1																					8'-0"	
MEN B1																					8'-0"	
MACHINE ROOM B1																					8'-0"	PROVIDE CONCRETE HARDENER AND SEALER
CLASSROOM B1																					8'-0"	
CLASSROOM B2																					8'-0"	
CLASSROOM B3																					8'-0"	
MECHANICAL ROOM																					8'-0"	PROVIDE CONCRETE HARDENER AND SEALER
CLASSROOM B4																					8'-0"	
CLASSROOM B5																					8'-0"	
CLASSROOM B6																					8'-0"	
SORAGE A																					8'-0"	
CONFERENCE B1																					8'-0"	
CLOSET																					8'-0"	
CORRIDOR B1																					8'-0"	
CORRIDOR B2																					8'-0"	
CORRIDOR B3																					8'-0"	
CORRIDOR B4																					8'-0"	
JANITOR'S RM. B1																					8'-0"	
LOBBY																					9'-0"	
SANCTUARY																					VARIES	
MEDIAROOM																					9'-0"	
CHOIRROOM																					9'-0"	
NURSES/FIRST AID																					9'-0"	
TRUSTEES/STEWARDS																					9'-0"	
CORRIDOR 1																					9'-0"	
FELLOWSHIP HALL																					9'-0"	
MECHANICALROOM																					9'-0"	PROVIDE CONCRETE HARDENER AND SEALER
ELECTRICALROOM																					9'-0"	PROVIDE CONCRETE HARDENER AND SEALER
CLASSROOM 1																					9'-0"	
CLASSROOM 2																					9'-0"	
STORAGE																					9'-0"	
KITCHEN																					8'-0"	
PANTRY																					9'-0"	
HALL																					9'-0"	
CORRIDOR 2																					9'-0"	
PASTOR'S OFFICE																					9'-0"	
CHURCH CLERK																					9'-0"	
MINISTERIAL STAFF																					9'-0"	
TOILETROOM MEN																					8'-0"	PROVIDE CERAMIC TILE WAINSCOT WHERE SHOWN
TOILETROOM WOMEN																					8'-0"	PROVIDE CERAMIC TILE WAINSCOT WHERE SHOWN
TOILETROOM CHOIR																					8'-0"	
TOILETROOM PASTOR'S OFFICE																					8'-0"	PROVIDE CERAMIC TILE WAINSCOT WHERE SHOWN

WALL TYPES
NO SCALE

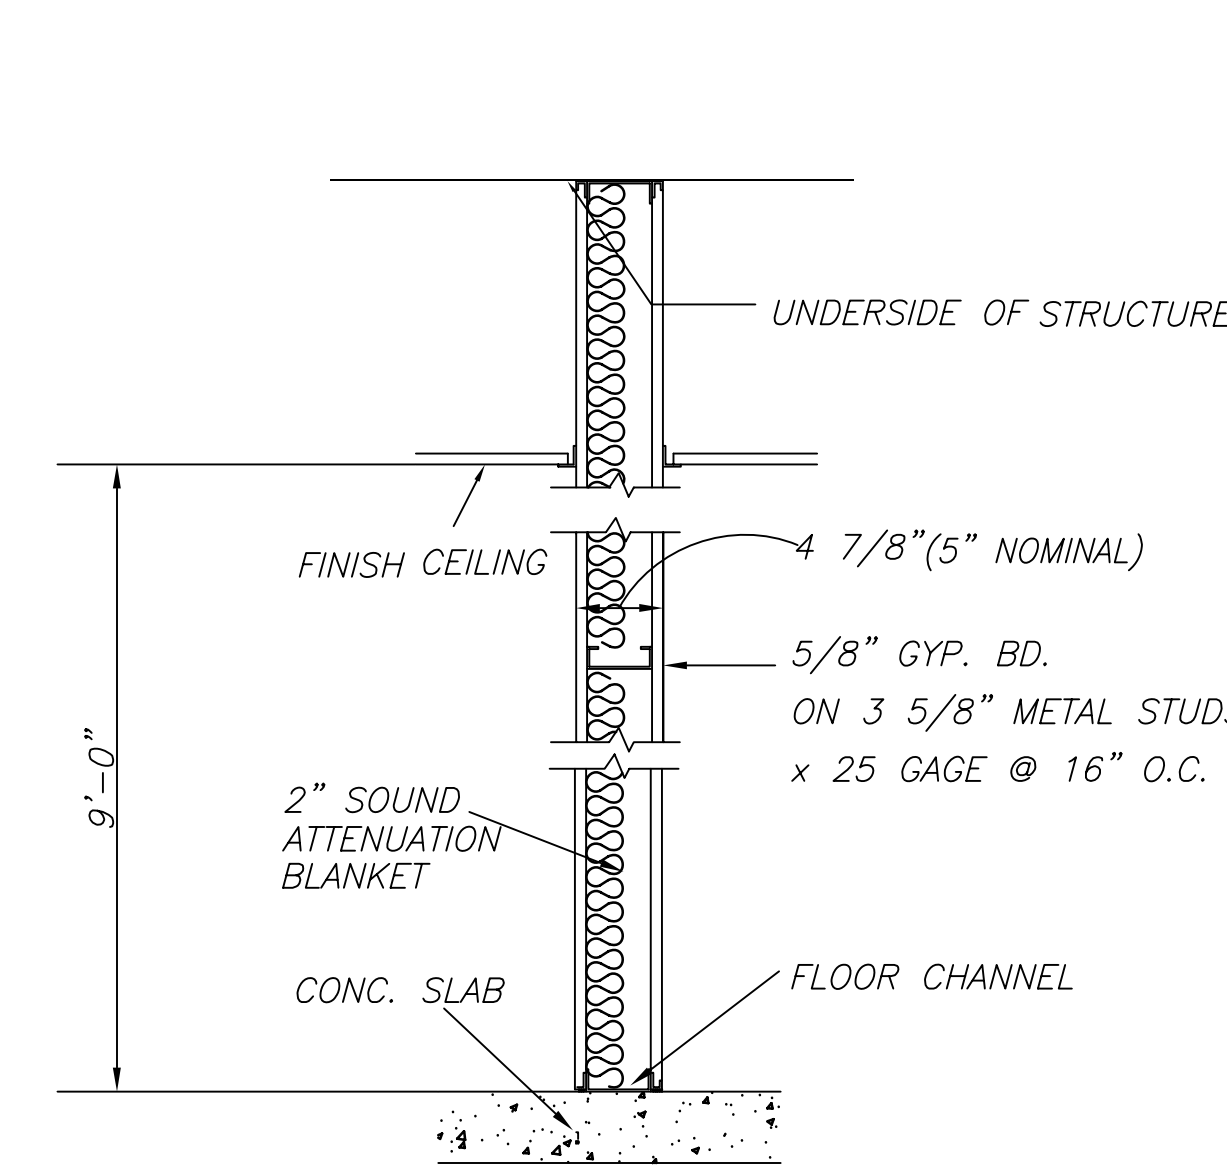

PARTITION TYPE 1

NOTE: PROVIDE 1 HR RATED CONSTRUCTION AT MECHANICAL & ELECTRICAL ROOM WALLS UL DESIGN NO. U465 AND PROVIDE DOUBLE LAYER 5/8" GYPSUMBOARD AT CEILINGS

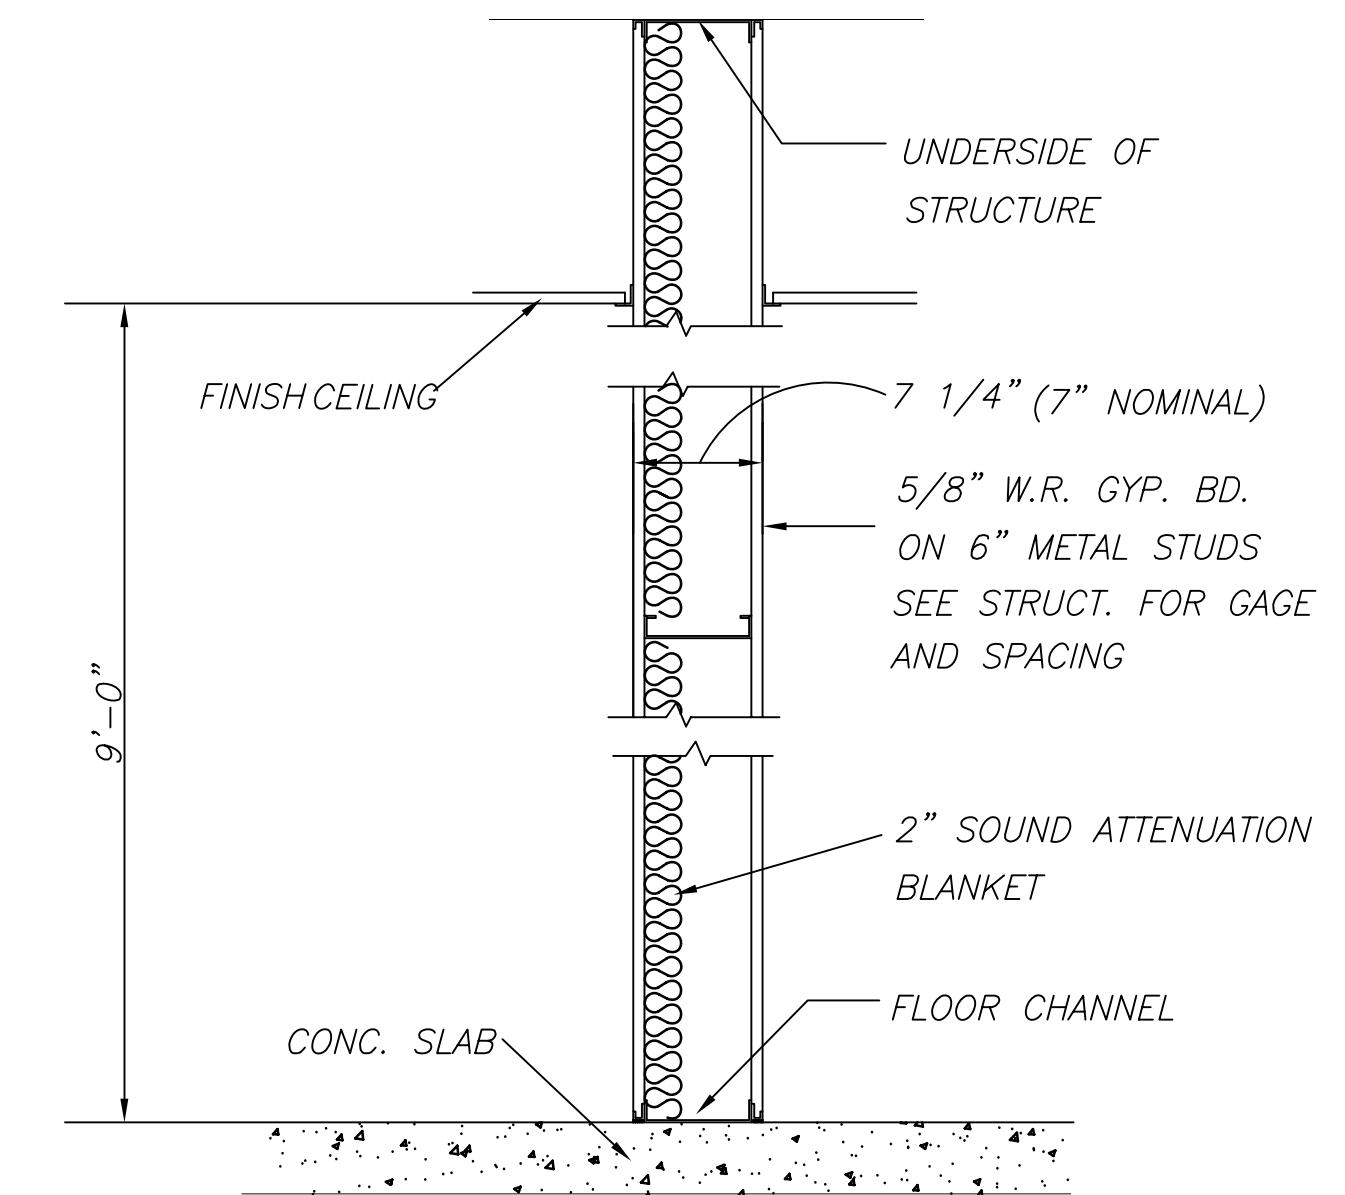


PARTITION TYPE 2


⊗ BEARING/SHEAR WALLS-SEE STRUCT.



PLAN INDICATION

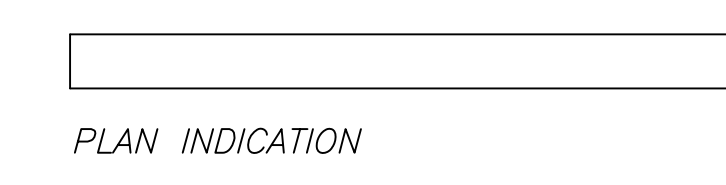

PLAN INDICATION

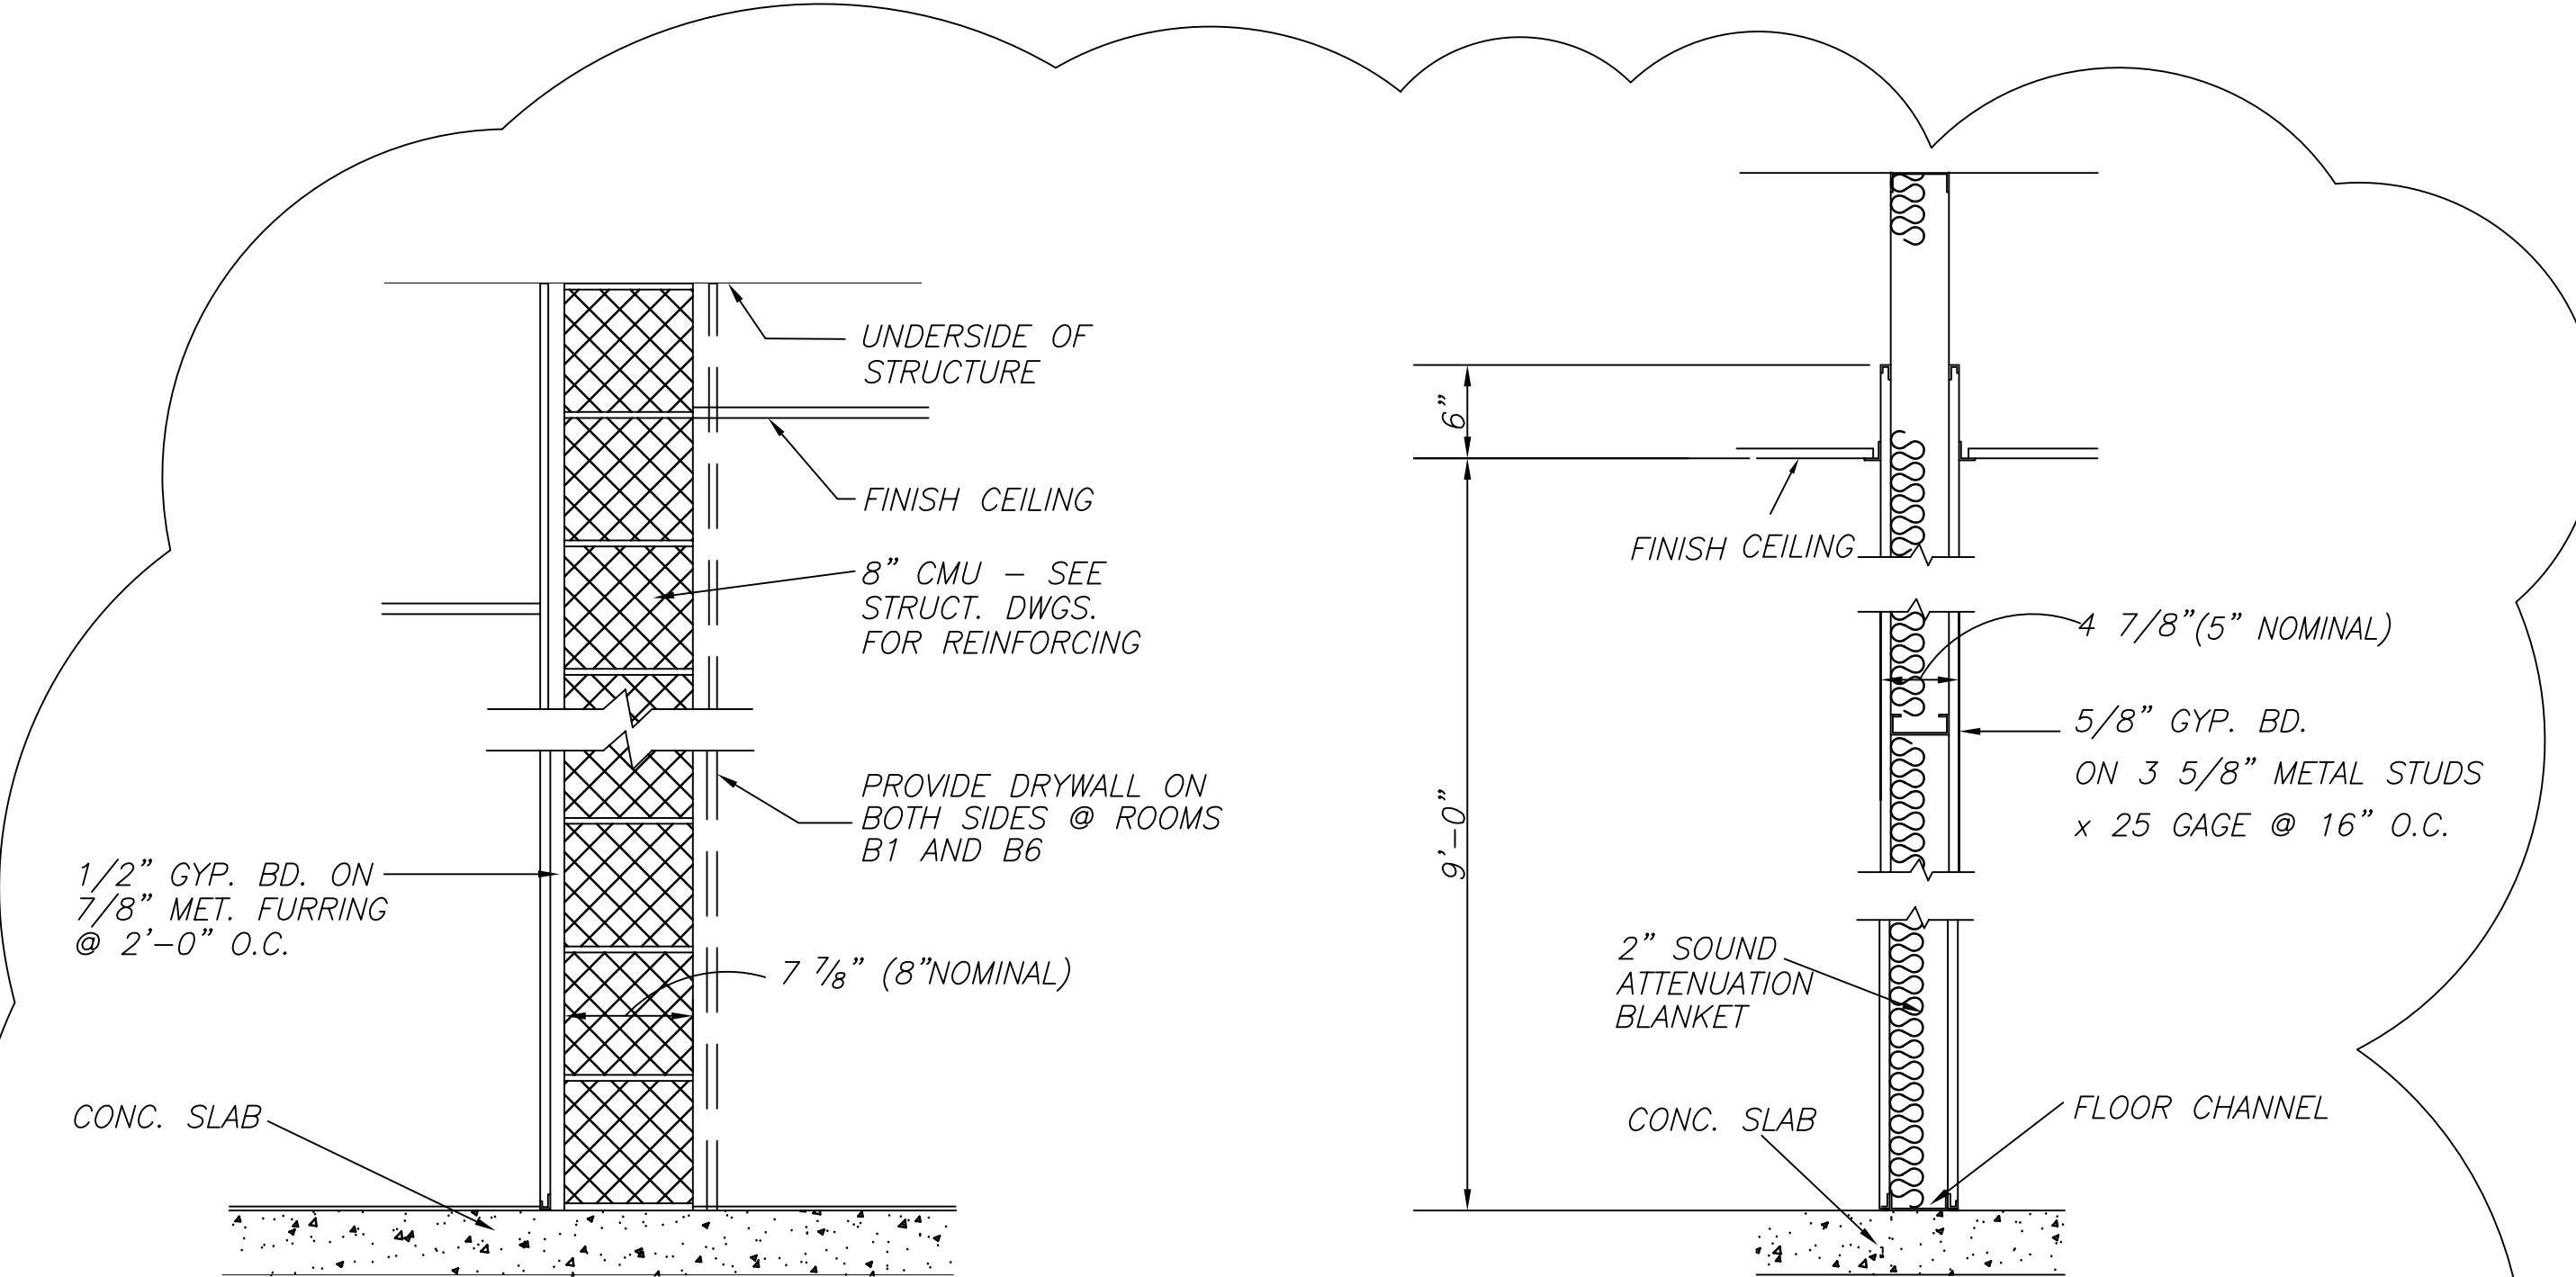


PARTITION TYPE 3

NOTE: PROVIDE 1 HR MINIMUM RATED CONSTRUCTION UL DESIGN NO. U905

PARTITION TYPE 4

PLAN INDICATION

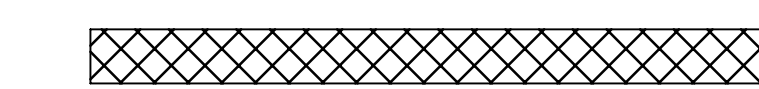

PLAN INDICATION

Copyright 2004 Philip Aaron Lacy, Architect. All rights reserved. No portion of this document may be reproduced without written permission.

Date: 07-14-08

Revisions:

1	COUNTY REVIEW COMMENTS
---	------------------------

Consultants:
WARDER & ASSOCIATES INC.
CHURCH EXPANSION SPECIALISTS
8016 OLD ALEXANDRIA FERRY ROAD
CLINTON, MARYLAND 20735
PHONE: 301-866-5900

Certification:

Project Title:
BETH SHALOM A.M.E. ZION CHURCH
2501 RITCHIE ROAD
DISTRICT HEIGHT, MARYLAND 20735

FINISH SCHEDULE AND WALL DETAILS

Philip Aaron Lacy, Architects
6188 Oxon Hill Road, Suite 303
Oxon Hill, Maryland 20745
Phone: 301-567-8223

Date: DEC. 1, 2005
Scale: AS SHOWN
Drawn: FCB
Checked: PAL
File No. BETH_A12

Drawing No.
A-12
of